



BARNSTABLE FIRE DISTRICT WATER DEPARTMENT


P.O. Box 546
Barnstable, Massachusetts 02630
Phone: 508-362-6498
www.barnstablefiredistrict.com

SOP #4

S.O.P for Water Service Drawings

1. Basic outline of building facing water service layout.
2. Size and length of each section of the water service.
3. General layout of service pipe.
4. Street address and service number.
5. Ties from permanent locations - preferably the structure that the service goes to. Unless distance is over 100' then use hydrants, telephone poles, electric transformer boxes or cable boxes.
6. Size of tapped main and location of tap (backside, 9 o'clock, etc.). With ties to tap location for ease of location in the future.
7. List of materials and manufacturer (indicate C/S opening L or R)
8. Street layout at property including location of main depth.
9. Date of installation and company who installed it.
10. Wire must extend into basement and attach to the water main.
11. Distance from corner of foundation to service access location.

These are general guidelines, however, may vary depending on circumstances.

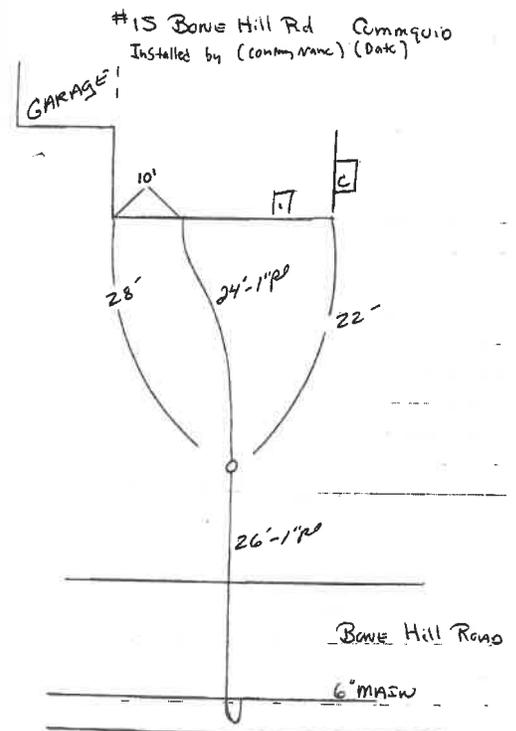

Parts List:
50' wire
50' 1" P.E. N.P. 200 PSI
1-1" Corp meter
1-1" U/S meter
1 Enc Box

Parrella